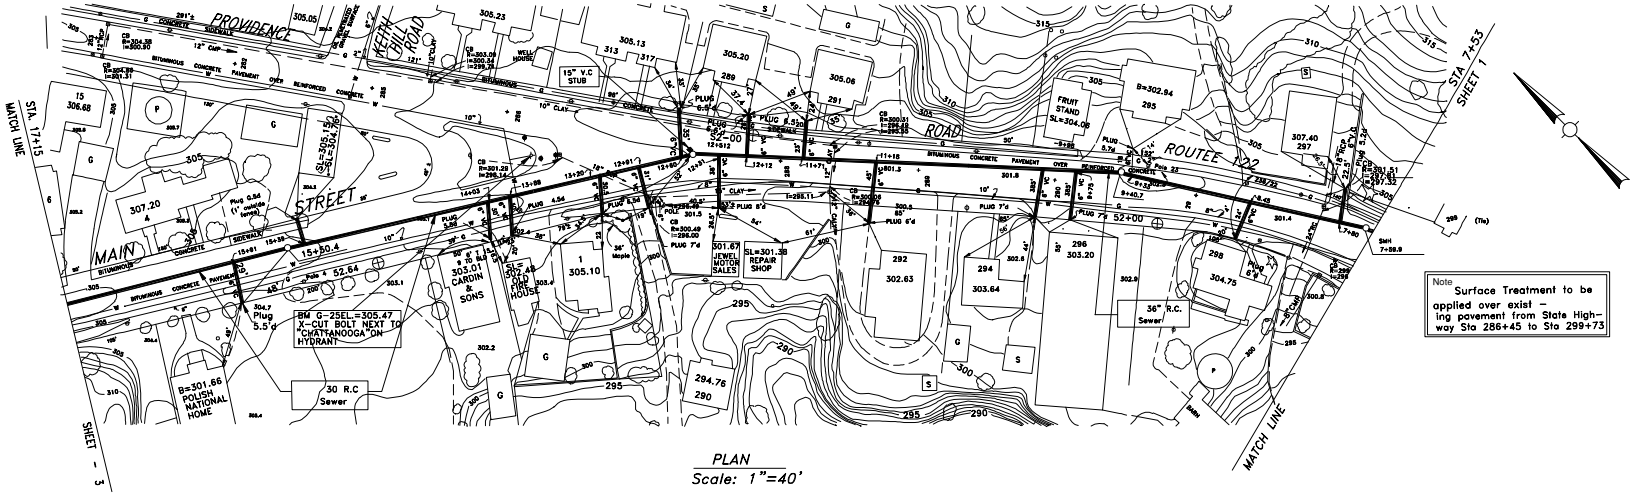

PLAN
Scale: 1"=40'

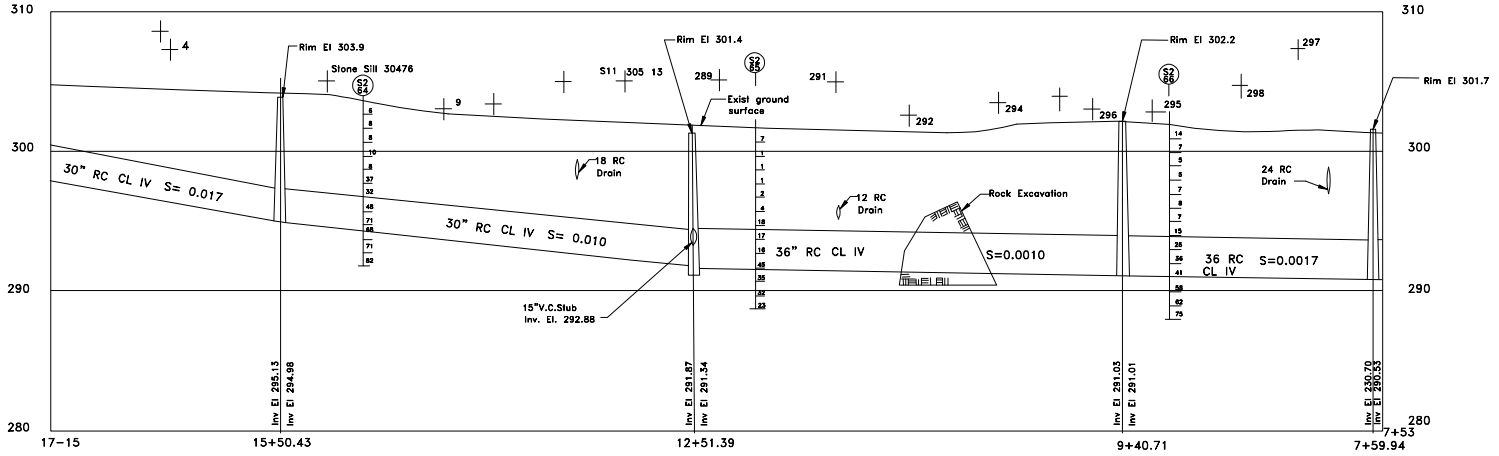

PROFILE
Scale: Hor 1"= 40'
Ver 1"= 4'

Approved by:	Date	Name
Structural		
Electrial		
HVAC		
Project Engineer		
Project Manager		

RECORD DRAWING

Date	Ch'k'd.	Revision
8/79	OM	REVISED FOR RECORD DRWAWING

Designed by: C.P.N.W.
Drawn by: A.Y.
Checked by: G.J.
Approved by: C.A.P.
Date: December 1975
Scale: As Noted

SAMPLE LAYOUT DRAWING

SHEET NO. 2
291-24643